


Based on Capacity Drawing:
Date of Capacity Capture:

Staff Car Parks

Park & Cycle

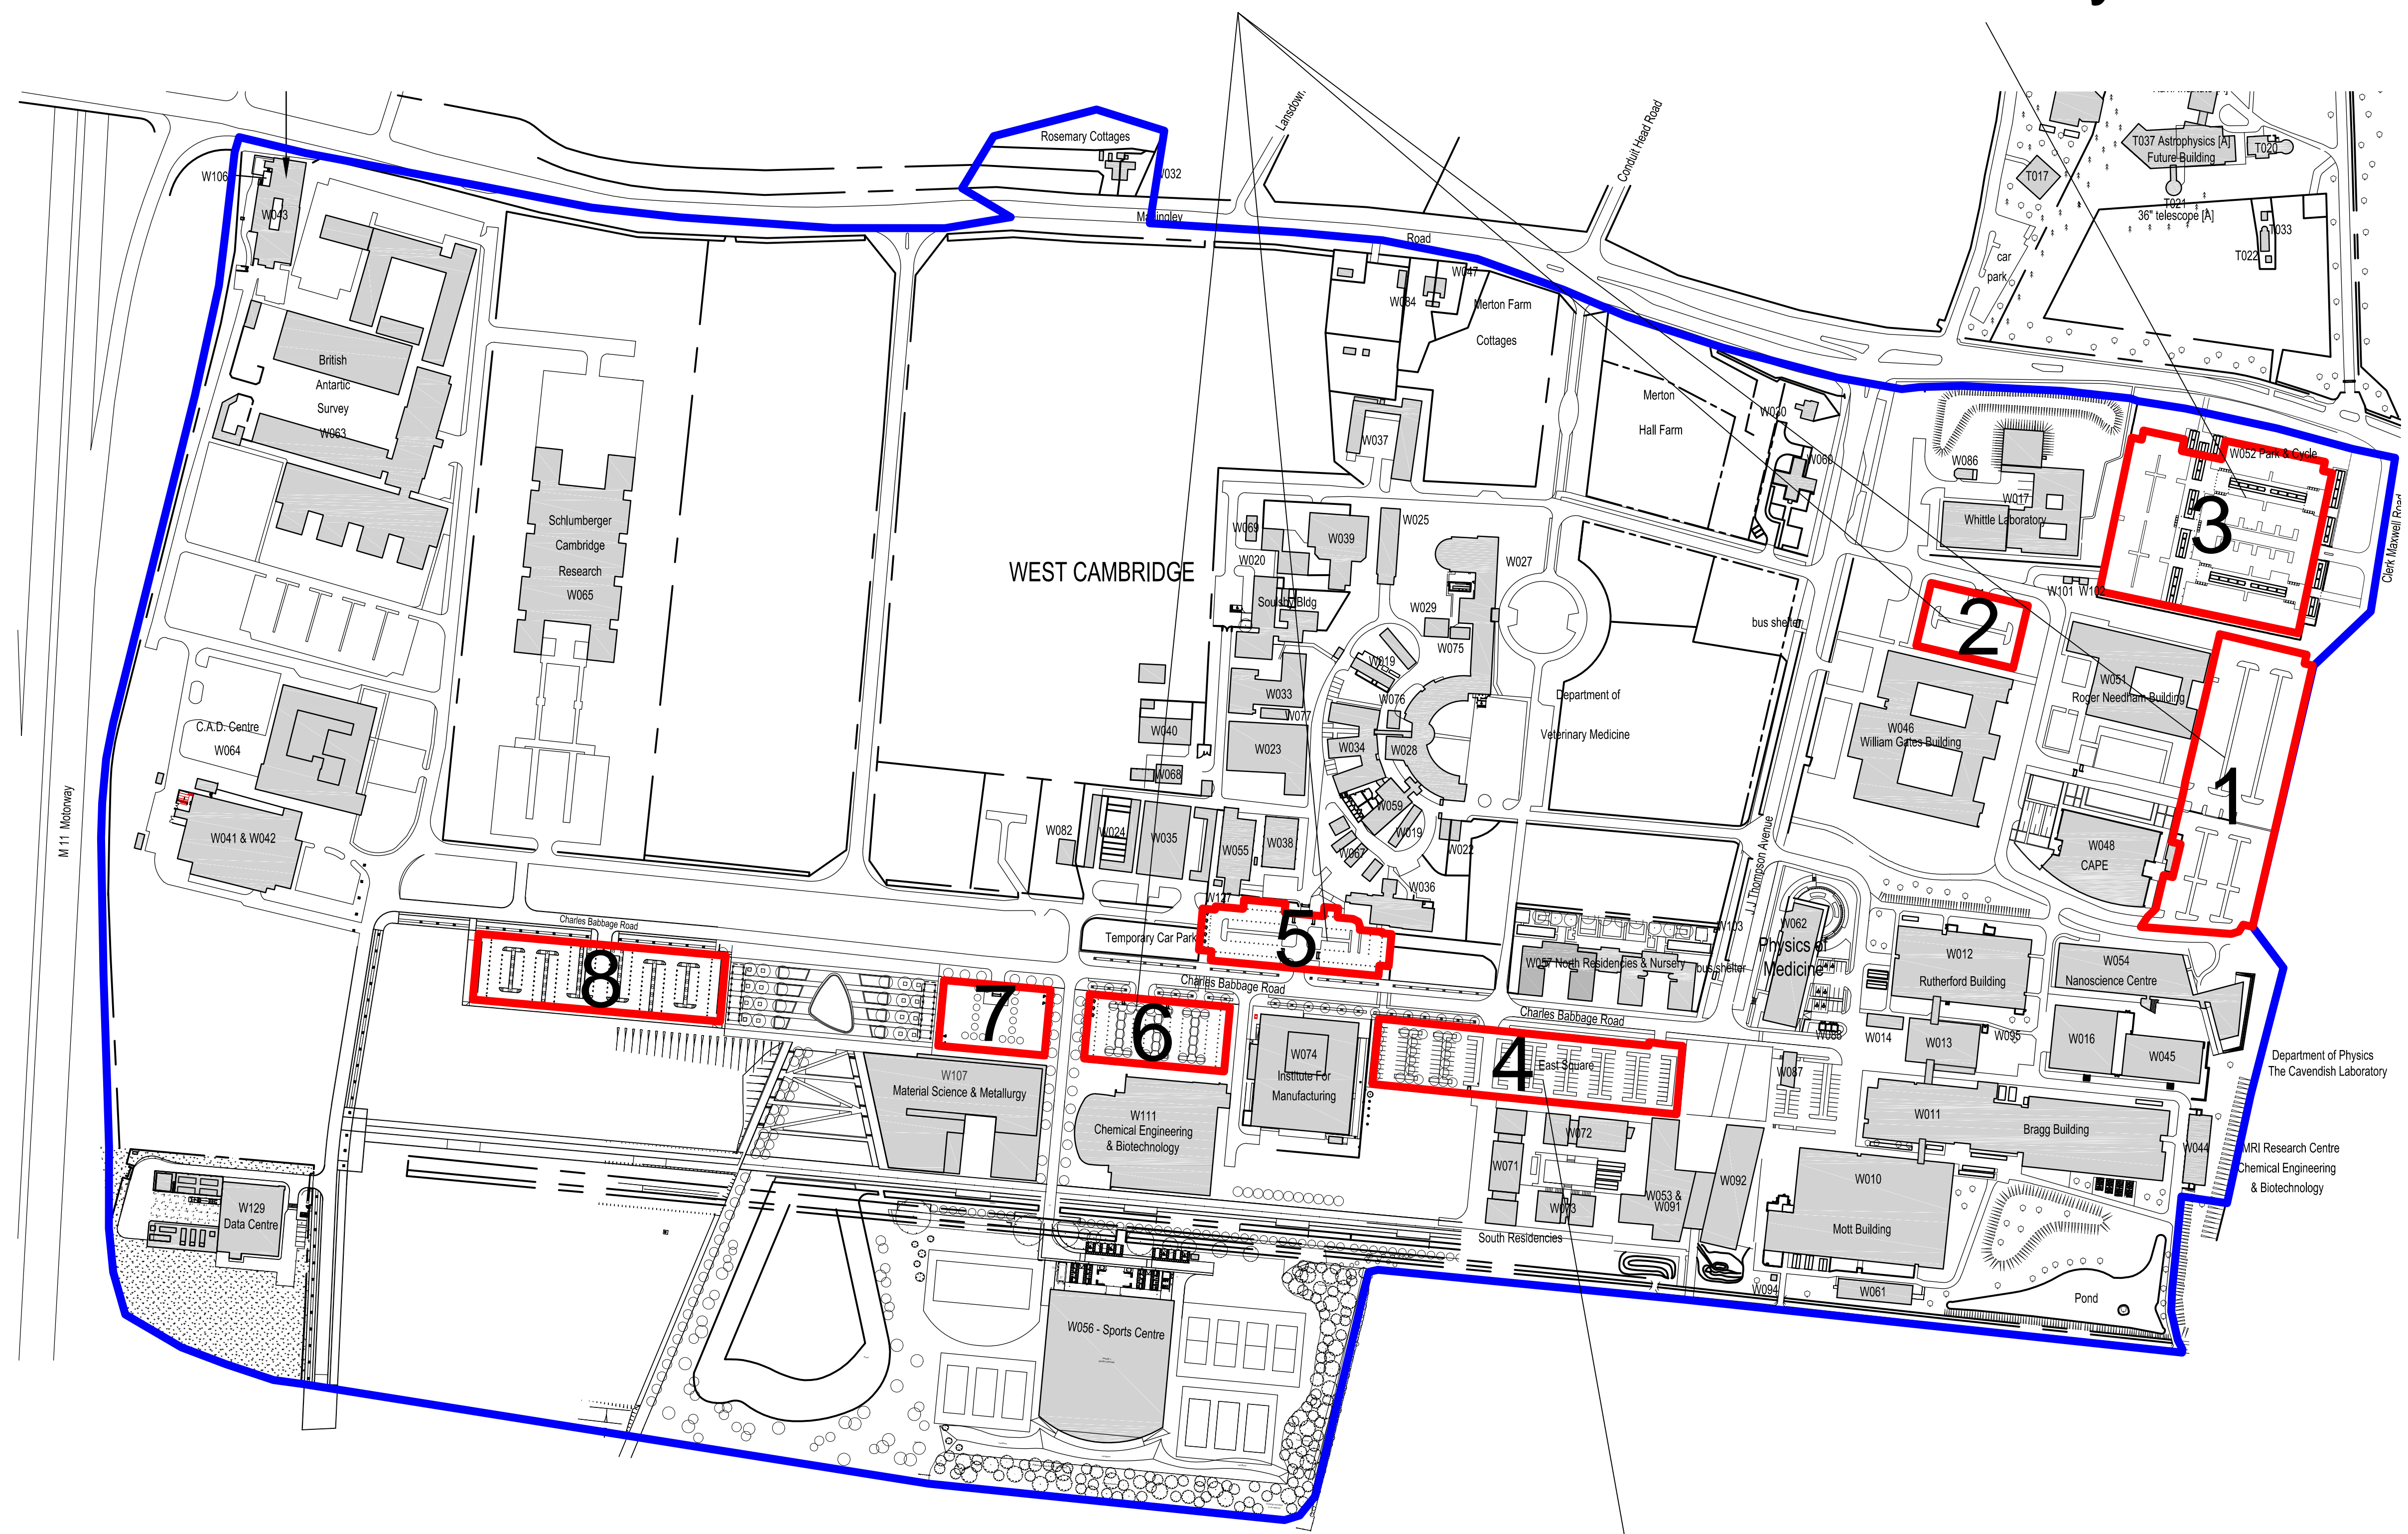

Visitors Car Park

Originators Project Number



74 Trumpington Street, Cambridge, CB2 1RW, Tel: 01223 337770

Project
As Built

Description
**West Cambridge Car Parking Site Plan
Site Location Plan
West Cambridge Site**

Scale	Date	Drawn	Checked
1:2500 @ A1	05/06/2014	Ig447	SM
Project	Owner	Status	Revision
	UOC	AB	P1

Drawing no
West Cambridge Car Park Site Plan